PENN BUILDERS, INC.
General Contractors

August 27, 2026

Mr. Jamie Lynch
CHA Consulting, Inc.
1 East Broad Street, Suite 310
Bethlehem, PA 18018

RE: North Penn High School BP-2
Change Order Request #25 AV Wall Change ASI #16

Dear Mr. Lynch:

Please see below the costs associated with the stud framing changes per ASI-16, which changed Classroom AV wall partition type to S4A in lieu of S2A.

Easy Does It (See proposal)	$ 18,776.47
Penn Builders, Inc OH&P (10%)	$ 1,877.65
	$ 20,654.12

Please issue an allowance adjustment or change order for this additional cost if approved.

Sincerely,
PENN BUILDERS, INC.
Dave Lawrence

CC: Ms. Marcie Sorber (SGA)
Mr. Bill Hambly (CHA)
Mr. Nagaraju Mudunuri (CHA)
Mr. Chris Horton (PBI)
Mr. Jon Swartley (PBI)
Mr. Harry Buzzard (PBI)
Mr. Jim Bodkin (PBI)
Ms. Valerie Brown (PBI)
FILE

2275 N. Old Bethlehem Pike Quakertown, PA 18951
215-536-8315

REQUEST FOR CHANGE ORDER

EASY DOES IT DRYWALL, INC. **July 30, 2026**
71 TEXACO ROAD
MECHANICSBURG, PA 17050

PROPOSAL SUBMITTED TO: Penn Builders
3949, 2275 N Old Bethlehem Pike,
Quakertown, PA 18951

JOB NAME: North Penn High School BP2

WE HEREBY SUBMIT SPECIFICATIONS AND ESTIMATES FOR:

REQUEST FOR CHANGE ORDER NO.6

Reference: Attached ASI 016 & Highlighted AV Walls for swap out.

- **Swap 2-1/2" 20ga Metal Framing to 4" 20ga Metal framing at AV walls per note E on Power Drawings.**

  ****excludes any other walls not highlighted in yellow, per our attached Arch Drawings****

We hereby propose to furnish the material and labor - complete in accordance with the above specifications, for the sum of:

Eighteen Thousand Seven Hundred Seventy-Six Dollars and 47/100 cents---------$18,776.47

_____
Nicholas Meinnert, Estimator

Due to fluctuation in material prices, the bid is good for fifteen (15) days only.

Acceptance of Proposal - The above prices, specifications and conditions are satisfactory and are hereby accepted. You are authorized to do the work as specified.

Signature_____ Date of Acceptance_____

COST BREAKDOWN

CONTRACTOR NAME SUB

North Penn High School BP2 CO006 ASI 016 Credit

LABOR COST

Classification	Certified Payroll Base Rate *	Fringe Benefits (as defined by L&I) *	Total Hourly Rate	Hours	Total
Carpenter	$76.49		$82.49		$0.00
Finisher	$76.78		$82.78		$0.00
Building Laborer	$63.35		$69.35		$0.00
Superintendent	$85.00		$85.00		$0.00
Project Manager	$125.00		$125.00		$0.00
				Sub-Total	**$0.00**

On Base Labor Rate ONLY

Social Security @	6.20%		$0.00
Medicare @	1.45%		$0.00
Unemployment @	11.00%		$0.00
Workmans Compensation @	10.00%		$0.00
Public Liability Insurance @	4.00%		$0.00
		Sub-Total	**$0.00**

** Labor Markup (10.00%) $0.00

TOTAL LABOR **$0.00**

MATERIAL COST (attach material list if necessary, insert totals as shown)

Item	Quantity	Unit Cost	Total Cost
Credit 2-1/2" x 14' 20ga Metal Stud/PC	-2,080	$8.89	($18,491.20)
Credit 2-1/2" 20ga Deflection Track/PC	-280	$17.26	($4,832.80)
Credit 2-1/2" 20ga Bottom Track/PC	-280	$6.30	($1,764.00)
Credit R8 Insulation/Bag	-201	$81.60	($16,401.60)
			$0.00
			$0.00
			$0.00
			$0.00
			$0.00
			$0.00
		Sub-Total	**($41,489.60)**

** Material Markup (0.00%) $0.00

*** Applicable Sales 6% Tax

MATERIAL TOTAL **($41,489.60)**

EQUIPMENT COST (equipment cost for owned equipment (depreciation, insurance, etc.) or documentation supporting lease of equipment)

Classification	Unit Rate	Month	Total Cost
			$0.00
			$0.00
		Sub-Total	**$0.00**

** Equipment Markup (10.00%) $0.00

EQUIPMENT TOTAL **$0.00**

LME TOTAL **($41,489.60)**

COST BREAKDOWN

CONTRACTOR NAME SUB

North Penn High School BP2 CO006 ASI 016

LABOR COST

Classification	Certified Payroll Base Rate *	Fringe Benefits (as defined by L&I) *	Total Hourly Rate	Hours	Total
Carpenter	$76.49		$82.49		$0.00
Finisher	$76.78		$82.78		$0.00
Building Laborer	$63.35		$69.35		$0.00
Superintendent	$85.00		$85.00	1	$85.00
Project Manager	$125.00		$125.00	1	$125.00
				Sub-Total	**$210.00**

On Base Labor Rate ONLY

Social Security @	6.20%		$13.02
Medicare @	1.45%		$3.05
Unemployment @	11.00%		$23.10
Workmans Compensation @	10.00%		$21.00
Public Liability Insurance @	4.00%		$8.40
		Sub-Total	**$68.57**

** Labor Markup (10.00%) $27.86

TOTAL LABOR **$306.42**

MATERIAL COST (attach material list if necessary, insert totals as shown)

Item	Quantity	Unit Cost	Total Cost
ADD 4" x 14' 20ga Metal Stud/PC	2,080	$12.53	$26,062.40
Credit 4" 20ga Deflection Track/PC	280	$18.70	$5,236.00
Credit 4" 20ga Bottom Track/PC	280	$8.90	$2,492.00
Credit R11 Insulation/Bag	227	$78.85	$17,898.95
			$0.00
			$0.00
			$0.00
			$0.00
			$0.00
			$0.00
		Sub-Total	**$51,689.35**

** Material Markup (10.00%) $5,168.94

*** Applicable Sales 6% Tax $3,101.36

MATERIAL TOTAL **$59,959.65**

EQUIPMENT COST (equipment cost for owned equipment (depreciation, insurance, etc.) or documentation supporting lease of equipment)

Classification	Unit Rate	Month	Total Cost
			$0.00
			$0.00
		Sub-Total	**$0.00**

** Equipment Markup (10.00%) $0.00

EQUIPMENT TOTAL **$0.00**

LME TOTAL **$60,266.07**

AIA® Document G710™ – 2017

Architect's Supplemental Instructions

PROJECT: *(name and address)*	**CONTRACT INFORMATION:**	**ASI INFORMATION:**
North Penn High School Renovations Bid Package 2	Contract For: Electrical Construction Date: 08/14/2025	ASI Number: 016 Date: 07/23/2026
OWNER: *(name and address)*	**ARCHITECT:** *(name and address)*	**CONTRACTOR:** *(name and address)*
North Penn School District 401 E. Hancock Street Landsdale, PA 19446	Hord Coplan Macht, Inc. d/b/a SCHRADERGROUP Studio 555 E. North Lane, Suite 5100 Conshohocken , PA 19428	Wescott Electric Company P.O. Box 278 Glen Riddle, PA 19037

The Contractor shall carry out the Work in accordance with the following supplemental instructions without change in Contract Sum or Contract Time. Proceeding with the Work in accordance with these instructions indicates your acknowledgment that there will be no change in the Contract Sum or Contract Time.
(Insert a detailed description of the Architect's supplemental instructions and, if applicable, attach or reference specific exhibits.)

Dated 07/23/2026 and generally encompassing Classroom AV Walls, clarifications and modifications to the contract scope of work include:

ASI 16.1	GC: S4A Partition at AV Classroom Walls
ASI 16.2	EC: AV Wall Box Clarification
ASI 16	MC & PC: ASI provided for informational purposes only.

ISSUED BY THE ARCHITECT:

ARCHITECT *(Signature)*

BY: Devin Bradbury, Associate Principal
(Printed name, title, and license number if required)

07/23/2026
Date

AIA Document G710 – 2017. Copyright © 1979, 1992 and 2017. All rights reserved. "The American Institute of Architects," "American Institute of Architects," "AIA," the AIA Logo, and "AIA Contract Documents" are trademarks of The American Institute of Architects. This document was produced at 09:41:08 EST on 03/04/2026 under Subscription No.20250098964 which expires on 02/15/2027, is not for resale, is licensed for one-time use only, and may only be used in accordance with the AIA Contract Documents® Terms of Service. To report copyright violations, e-mail docinfo@aiacontracts.com.
User Notes: (69a8426d3a53e4fcd27e4fae)

AIA® Document G710™ – 2017

Architect's Supplemental Instructions

PROJECT: *(name and address)*	**CONTRACT INFORMATION:**	**ASI INFORMATION:**
North Penn High School Renovation Bid Package 2	Contract For: General Construction Date: 08/14/2025	ASI Number: 016 Date: 07/23/2026
OWNER: *(name and address)*	**ARCHITECT:** *(name and address)*	**CONTRACTOR:** *(name and address)*
North Penn School District 401 E. Hancock Street Landsdale, PA 19446	Hord Coplan Macht, Inc. d/b/a SCHRADERGROUP Studio 555 E. North Lane, Suite 5100 Conshohocken , PA 19428	Penn Builders, Inc 2275 Od Bethlehem Pike Quakertown, PA 18951

The Contractor shall carry out the Work in accordance with the following supplemental instructions without change in Contract Sum or Contract Time. Proceeding with the Work in accordance with these instructions indicates your acknowledgment that there will be no change in the Contract Sum or Contract Time.
(Insert a detailed description of the Architect's supplemental instructions and, if applicable, attach or reference specific exhibits.)

Dated 07/23/2026 and generally encompassing Classroom AV Walls, clarifications and modifications to the contract scope of work include:

ASI 16.1	GC: S4A Partition at AV Classroom Walls
ASI 16.2	EC: AV Wall Box Clarification
ASI 16	MC & PC: ASI provided for informational purposes only.

ISSUED BY THE ARCHITECT:

ARCHITECT *(Signature)*

BY: Devin Bradbury, Associate Principal

(Printed name, title, and license number if required)

07/23/2026

Date

AIA Document G710 – 2017. Copyright © 1979, 1992 and 2017. All rights reserved. "The American Institute of Architects," "American Institute of Architects," "AIA," the AIA Logo, and "AIA Contract Documents" are trademarks of The American Institute of Architects. This document was produced at 09:39:23 EST on 03/04/2026 under Subscription No.20250098964 which expires on 02/15/2027, is not for resale, is licensed for one-time use only, and may only be used in accordance with the AIA Contract Documents® Terms of Service. To report copyright violations, e-mail docinfo@aiacontracts.com.
User Notes: (69a843a83a53e4fcd27e4fcd)

ARCHITECT'S SUPPLEMENTAL INSTRUCTIONS (ASI) 16
CLASSROOM AV WALLS

To:	All Contractors
Project Name:	Additions and Renovations to: North Penn High School – Bid Package 2 (BP2) 1340 S. Valley Forge Rd. Landsdale, PA 19446
Prepared for:	North Penn School District 401 E. Hancock Street Landsdale, PA 19446
Date:	23 July 2026

Notice to all Contractors contracted to the North Penn High School BP2 project, this ASI is to amend or clarify the Contract documents as follows:

GENERAL

A. This ASI constitutes part of the Project Manual and Contract. Should conflict occur between the Project Manual and items in this ASI or between Drawings and this ASI, the ASI shall govern.

B. Work described in this ASI shall be in accordance with Specifications for like items in remainder of building and complete with all labor and materials required.

C. Contractors are requested to attach a copy of this ASI to the Project Manual in their possession.

D. Work affected by items in this ASI shall be appropriately adjusted to accommodate these changes.

Per specification 012600 – CONTRACT MODIFICATION PROCEDURES, this ASI authorizes Minor Changes in the Work, not involving adjustment to the Contract Sum or the Contract Time.

Should any Contractor find that the proposed changes in the Work will require modifications to the Contract through Allowance Adjustment or Change Order, the Contractor shall submit a Proposal Request to the Architect and Construction Manager within 14 days of receipt of this ASI.

ASI 16 ITEMIZED SCOPE

ASI 16.1	GC: S4A Partition at AV Classroom Walls
ASI 16.2	EC: AV Wall Box Clarification
ASI 16	MC & PC: ASI provided for informational purposes only.

NARRATIVE

16.01 Architectural BP2-A110 Series Drawings: Revise Classroom AV wall partition type to S4A in lieu of S2A.

16.02 Electrical Detail 9 / BP2-E503: E.C. shall provide wall box in appropriate size to accommodate 3″ depth requirement and (2) 1.5″ conduits as indicated on detail. Detail does not indicate standard 2 gang box.

SPECIFICATIONS

16.03 None released with ASI 16.

DRAWINGS

16.04 None released with ASI 16.

SKETCHES

16.05 None released with ASI 16.

ATTACHMENTS

None

END OF ASI 16

1. PREFIX CODES (CORE TYPES)

   S METAL STUD
   M MASONRY

2. FINISH CODES

   A (1) LAYER OF FINISH ON ONE SIDE
   B (2) LAYERS OF FINISH ON ONE SIDE
   C (1) LAYER OF FINISH ON BOTH SIDES
   D (2) LAYERS OF FINISH ON BOTH SIDES
   E (1) LAYER OF FINISH ON ONE SIDE, (2) LAYERS ON THE OTHER SIDE

3. RATING CODES

   X 1 HOUR FIRE RATED
   Z 2 HOUR FIRE RATED

4. SPECIAL CONDITION CODES

   CT WALL RECEIVES CERAMIC TILE FINISH OVER 5', REFERENCE GENERAL NOTE 41 ON A003. REFERENCE SPECIFICATIONS FOR SURFACE PREP REQUIREMENTS.

   HW HALF HEIGHT WALL, REFERENCE DETAILS FOR SPECIFIC WALL HEIGHT

   IR IMPACT RESISTANT GYPSUM WALL BOARD TO 10' ABOVE FINISHED FLOOR

   WG WALL RECIEVES VINYL WALL GRAPHIC, REFERENCE SPECIFICATIONS FOR SURFACE PREP REQUIREMENTS. REFERENCE ELEVATIONS FOR DIMENSIONS.

GENERAL PLAN NOTES

1. ALL DIMENSIONS ARE TO OUTSIDE FACE OF FOUNDATIONS, COLUMN LINE, OR FACE OF FRAMING UNLESS NOTED OTHERWISE. CONTRACTOR SHALL VERIFY DIMENSIONS PRIOR TO CONSTRUCTION AND NOTIFY ARCHITECT IMMEDIATELY OF ANY DISCREPANCIES.
2. SEE ENLARGED PLANS FOR TYPICAL INTERIOR ELEVATIONS.
3. FRAMING AND WALL FINISH SHALL BE CONTINUOUS ABOVE AND BELOW ALL WINDOW SYSTEMS.


NOT IN SCOPE

NEW CONCRETE SLAB, REFERENCE FLOOR PLANS FOR FLOOR HEIGHT

INFILL AREA. PROVIDE NEW CONCRETE SLAB FLUSH WITH EXISTING SLAB.

FROST SLAB, COORDINATE WITH SIDEWALK LAYOUT. REF. STRUCTURAL DRAWINGS FOR DETAIL.

NOTE: COORDINATE SLOPED SLAB W/ DRAINS. SEE STRUCTURAL AND PLUMBING DWGS.

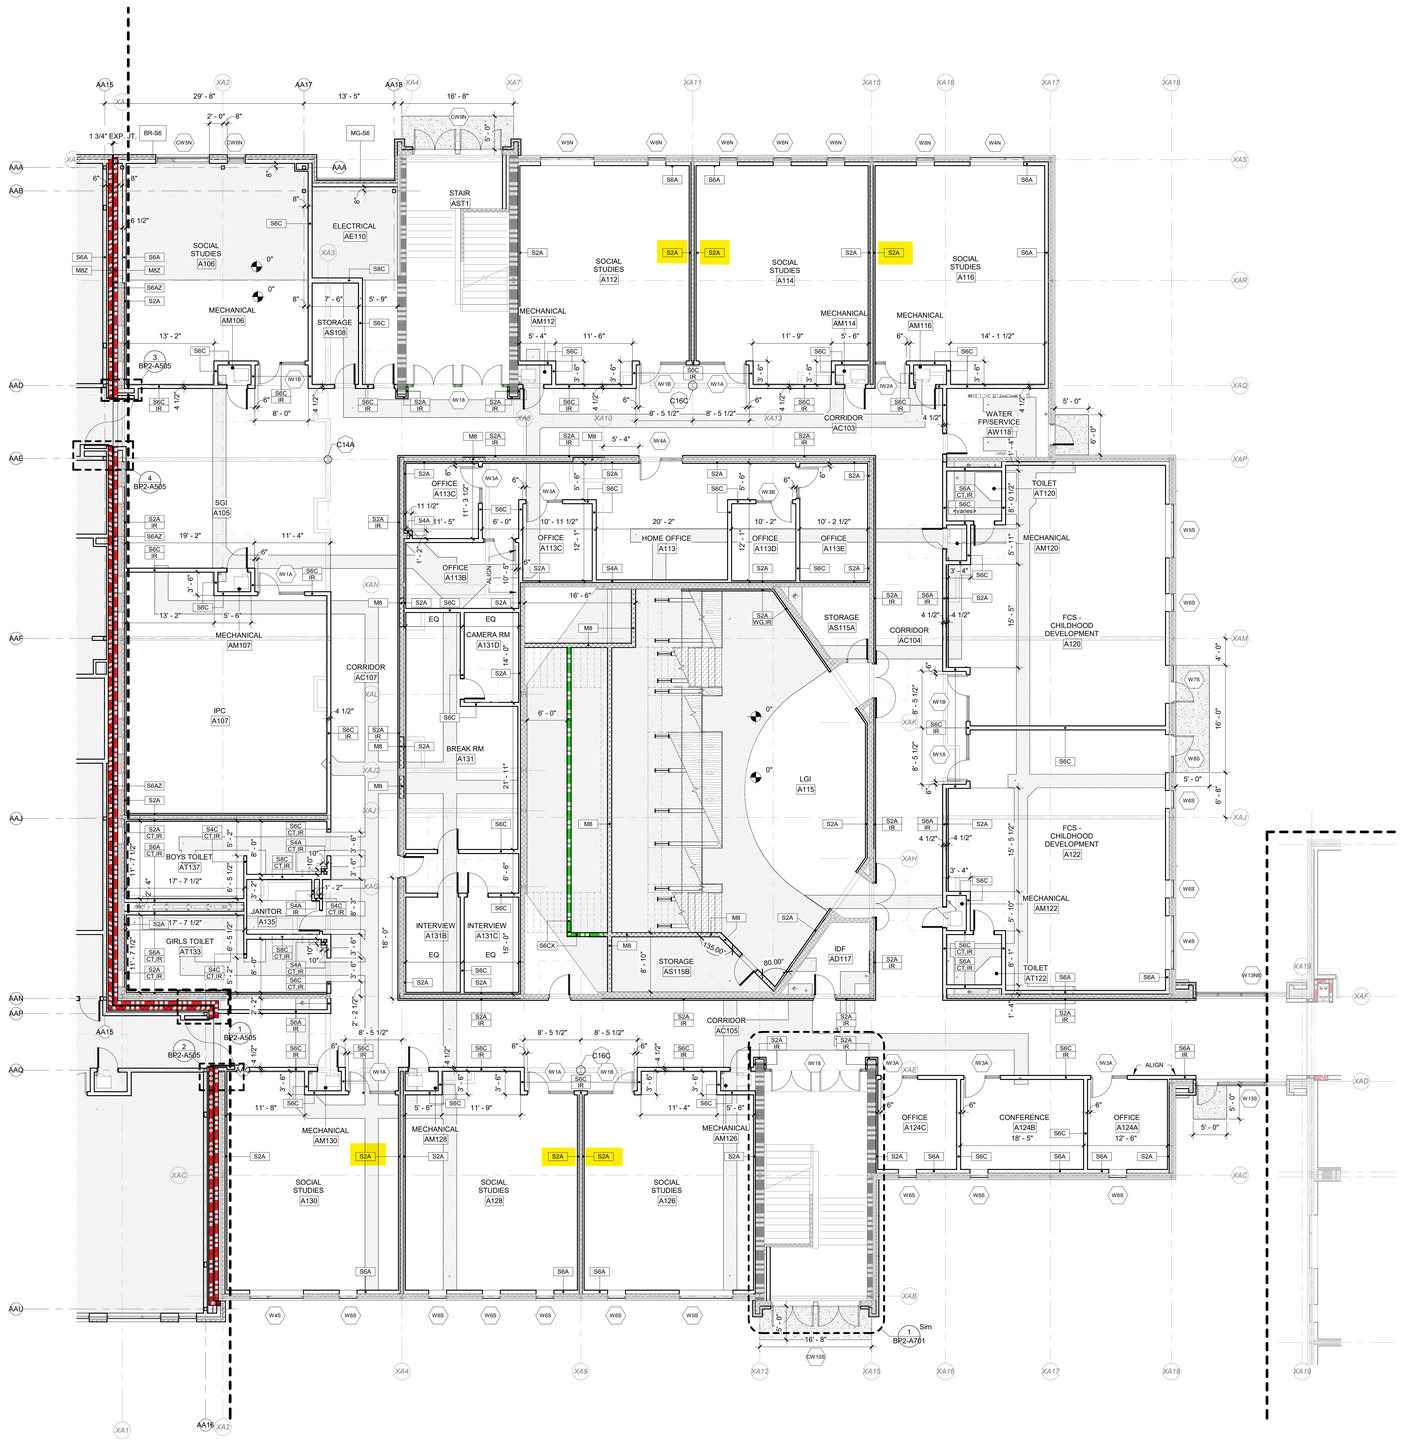

1 PARTIAL FIRST FLOOR PLAN - AREA A2
BP2-A111.A2 SCALE: 1/8" = 1'-0"

SCHRADERGROUP
555 E North Lane, Suite 5100, Building D,
Conshohocken, PA 19428
p: 215 482 7440
f: 215 482 7441
www.sgarc.com

Consultants:

Civil:
T&M ASSOCIATES
1700 Market St, Suite 3110
Philadelphia, PA 19103
p: 215.282.7850

MEP:
Snyder Hoffman Associates, Inc.
1005 W. Lehigh St.
Bethlehem, PA 18018
p: 610.694.8020

Structural Engineer
SCHRADERGROUP
153 East King St. Suite 211-212
Lancaster, PA 17602
p: 717.299.8965

Food Service
Corsi Associates
1489 Baltimore Pike
Springfield, PA 19064
p: 866.267.7447

Acoustics
Metropolitan Acoustics
1628 John F Kennedy Blvd #1902
Philadelphia, PA 19103
p: 215.248.4352

Professional Seal:



Owner:
NORTH PENN SCHOOL DISTRICT
401 E. HANCOCK STREET, LANSDALE, PA 19446

Additions and Renovations to:
NORTH PENN HIGH SCHOOL - BID PACKAGE 2 (BP2)
1340 S. VALLEY FORGE RD.
LANSDALE, PA 19446

ISSUED FOR:

NO.	DESCRIPTION	DATE
AD8	ADDENDUM #8	07/17/2025
AD9	ADDENDUM #9	07/24/2025
	CONFORMED SET	10/08/2025

DATE: 05/19/2025


SG PROJECT NUMBER: 23-028

Key Plan:



Drawing Title:
PARTIAL FIRST FLOOR DIMENSION PLAN - AREA A2

Drawing Number:
BP2-A111.A2

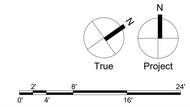

CONFORMED SET

1. PREFIX CODES (CORE TYPES)

S METAL STUD
M MASONRY

2. FINISH CODES

A (1) LAYER OF FINISH ON ONE SIDE
B (2) LAYERS OF FINISH ON ONE SIDE
C (1) LAYER OF FINISH ON BOTH SIDES
D (2) LAYERS OF FINISH ON BOTH SIDES
E (1) LAYER OF FINISH ON ONE SIDE, (2) LAYERS ON THE OTHER SIDE

3. RATING CODES

X 1 HOUR FIRE RATED
Z 2 HOUR FIRE RATED

4. SPECIAL CONDITION CODES

CT WALL RECEIVES CERAMIC TILE FINISH OVER 5', REFERENCE GENERAL NOTE 41 ON A003. REFERENCE SPECIFICATIONS FOR SURFACE PREP REQUIREMENTS.

HW HALF HEIGHT WALL. REFERENCE DETAILS FOR SPECIFIC WALL HEIGHT

IR IMPACT RESISTANT GYPSUM WALL BOARD TO 10' ABOVE FINISHED FLOOR

WG WALL RECIEVES VINYL WALL GRAPHIC. REFERENCE SPECIFICATIONS FOR SURFACE PREP REQUIREMENTS. REFERENCE ELEVATIONS FOR DIMENSIONS.

GENERAL PLAN NOTES

1. ALL DIMENSIONS ARE TO OUTSIDE FACE OF FOUNDATIONS, COLUMN LINE, OR FACE OF FRAMING UNLESS NOTED OTHERWISE. CONTRACTOR SHALL VERIFY DIMENSIONS PRIOR TO CONSTRUCTION AND NOTIFY ARCHITECT IMMEDIATELY OF ANY DISCREPANCIES.
2. SEE ENLARGED PLANS FOR TYPICAL INTERIOR ELEVATIONS.
3. FRAMING AND WALL FINISH SHALL BE CONTINUOUS ABOVE AND BELOW ALL WINDOW SYSTEMS.


NOT IN SCOPE

NEW CONCRETE SLAB. REFERENCE FLOOR PLANS FOR FLOOR HEIGHT

INFILL AREA. PROVIDE NEW CONCRETE SLAB FLUSH WITH EXISTING SLAB.

FROST SLAB, COORDINATE WITH SIDEWALK LAYOUT. REF. STRUCTURAL DRAWINGS FOR DETAIL.

NOTE: COORDINATE SLOPED SLAB W/ DRAINS. SEE STRUCTURAL AND PLUMBING DWGS.

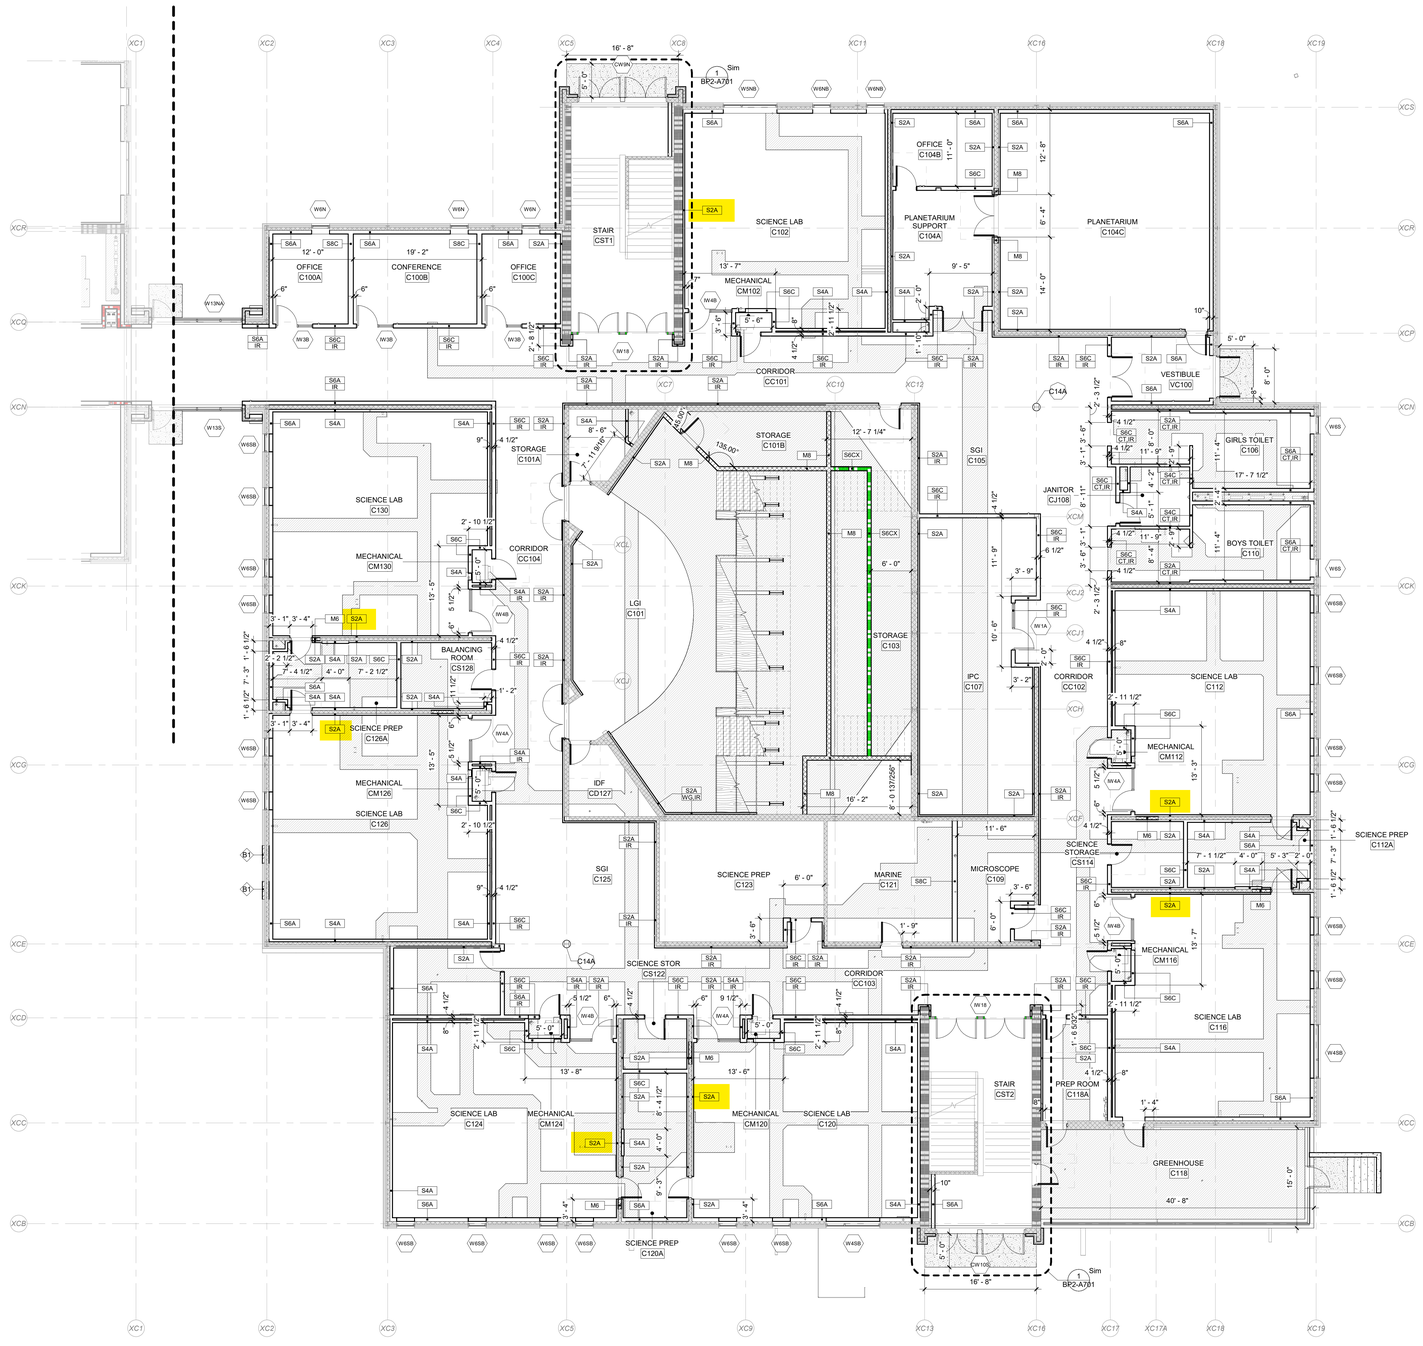

1 PARTIAL FIRST FLOOR PLAN - AREA C
BP2-A111.C SCALE: 1/8" = 1'-0"

SCHRADERGROUP
555 E North Lane, Suite 5100, Building D,
Conshohocken, PA 19428
p: 215 482 7440
f: 215 482 7441
www.sgarc.com

Consultants:

Civil:
T&M ASSOCIATES
1700 Market St, Suite 3110
Philadelphia, PA 19103
p: 215.282.7850

MEP:
Snyder Hoffman Associates, Inc.
1005 W. Lehigh St.
Bethlehem, PA 18018
p: 610.694.8020

Structural Engineer
SCHRADERGROUP
153 East King St. Suite 211-212
Lancaster, PA 17602
p: 717.299.8965

Food Service
Corsi Associates
1489 Baltimore Pike
Springfield, PA 19064
p: 866.267.7447

Acoustics
Metropolitan Acoustics
1628 John F Kennedy Blvd #1902
Philadelphia, PA 19103
p: 215.248.4352

Professional Seal:



Owner:
NORTH PENN SCHOOL DISTRICT
401 E. HANCOCK STREET, LANSDALE, PA 19446

Additions and Renovations to:
NORTH PENN HIGH SCHOOL - BID PACKAGE 2 (BP2)
1340 S. VALLEY FORGE RD.
LANSDALE, PA 19446

ISSUED FOR:

NO.	DESCRIPTION	DATE
AD7	ADDENDUM #7	07/10/2025
AD9	ADDENDUM #9	07/24/2025
	CONFORMED SET	10/08/2025

DATE: 05/19/2025


SG PROJECT NUMBER: 23-028

Key Plan:
NOT IN SCOPE



Drawing Title:
PARTIAL FIRST FLOOR DIMENSION PLAN - AREA C

Drawing Number:
BP2-A111.C

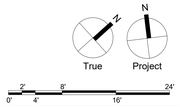

CONFORMED SET

1. PREFIX CODES (CORE TYPES)

   S METAL STUD
   M MASONRY

2. FINISH CODES

   A (1) LAYER OF FINISH ON ONE SIDE
   B (2) LAYERS OF FINISH ON ONE SIDE
   C (1) LAYER OF FINISH ON BOTH SIDES
   D (2) LAYERS OF FINISH ON BOTH SIDES
   E (1) LAYER OF FINISH ON ONE SIDE, (2) LAYERS ON THE OTHER SIDE

3. RATING CODES

   X 1 HOUR FIRE RATED
   Z 2 HOUR FIRE RATED

4. SPECIAL CONDITION CODES

   CT WALL RECEIVES CERAMIC TILE FINISH OVER 5', REFERENCE GENERAL NOTE 41 ON A003. REFERENCE SPECIFICATIONS FOR SURFACE PREP REQUIREMENTS.

   HW HALF HEIGHT WALL, REFERENCE DETAILS FOR SPECIFIC WALL HEIGHT

   IR IMPACT RESISTANT GYPSUM WALL BOARD TO 10' ABOVE FINISHED FLOOR

   WG WALL RECIEVES VINYL WALL GRAPHIC. REFERENCE SPECIFICATIONS FOR SURFACE PREP REQUIREMENTS. REFERENCE ELEVATIONS FOR DIMENSIONS.

GENERAL PLAN NOTES

1. ALL DIMENSIONS ARE TO OUTSIDE FACE OF FOUNDATIONS, COLUMN LINE, OR FACE OF FRAMING UNLESS NOTED OTHERWISE. CONTRACTOR SHALL VERIFY DIMENSIONS PRIOR TO CONSTRUCTION AND NOTIFY ARCHITECT IMMEDIATELY OF ANY DISCREPANCIES.
2. SEE ENLARGED PLANS FOR TYPICAL INTERIOR ELEVATIONS.
3. FRAMING AND WALL FINISH SHALL BE CONTINUOUS ABOVE AND BELOW ALL WINDOW SYSTEMS.

NOT IN SCOPE

NEW CONCRETE SLAB, REFERENCE FLOOR PLANS FOR FLOOR HEIGHT

INFILL AREA. PROVIDE NEW CONCRETE SLAB FLUSH WITH EXISTING SLAB.


FROST SLAB, COORDINATE WITH SIDEWALK LAYOUT. REF. STRUCTURAL DRAWINGS FOR DETAIL.

NOTE: COORDINATE SLOPED SLAB W/ DRAINS. SEE STRUCTURAL AND PLUMBING DWGS.



2 PARTIAL FIRST FLOOR PLAN - AREA E/F CONNECTOR
BP2-A111.E SCALE: 1/8" = 1'-0"

1 PARTIAL FIRST FLOOR PLAN - AREA E
BP2-A111.E SCALE: 1/8" = 1'-0"

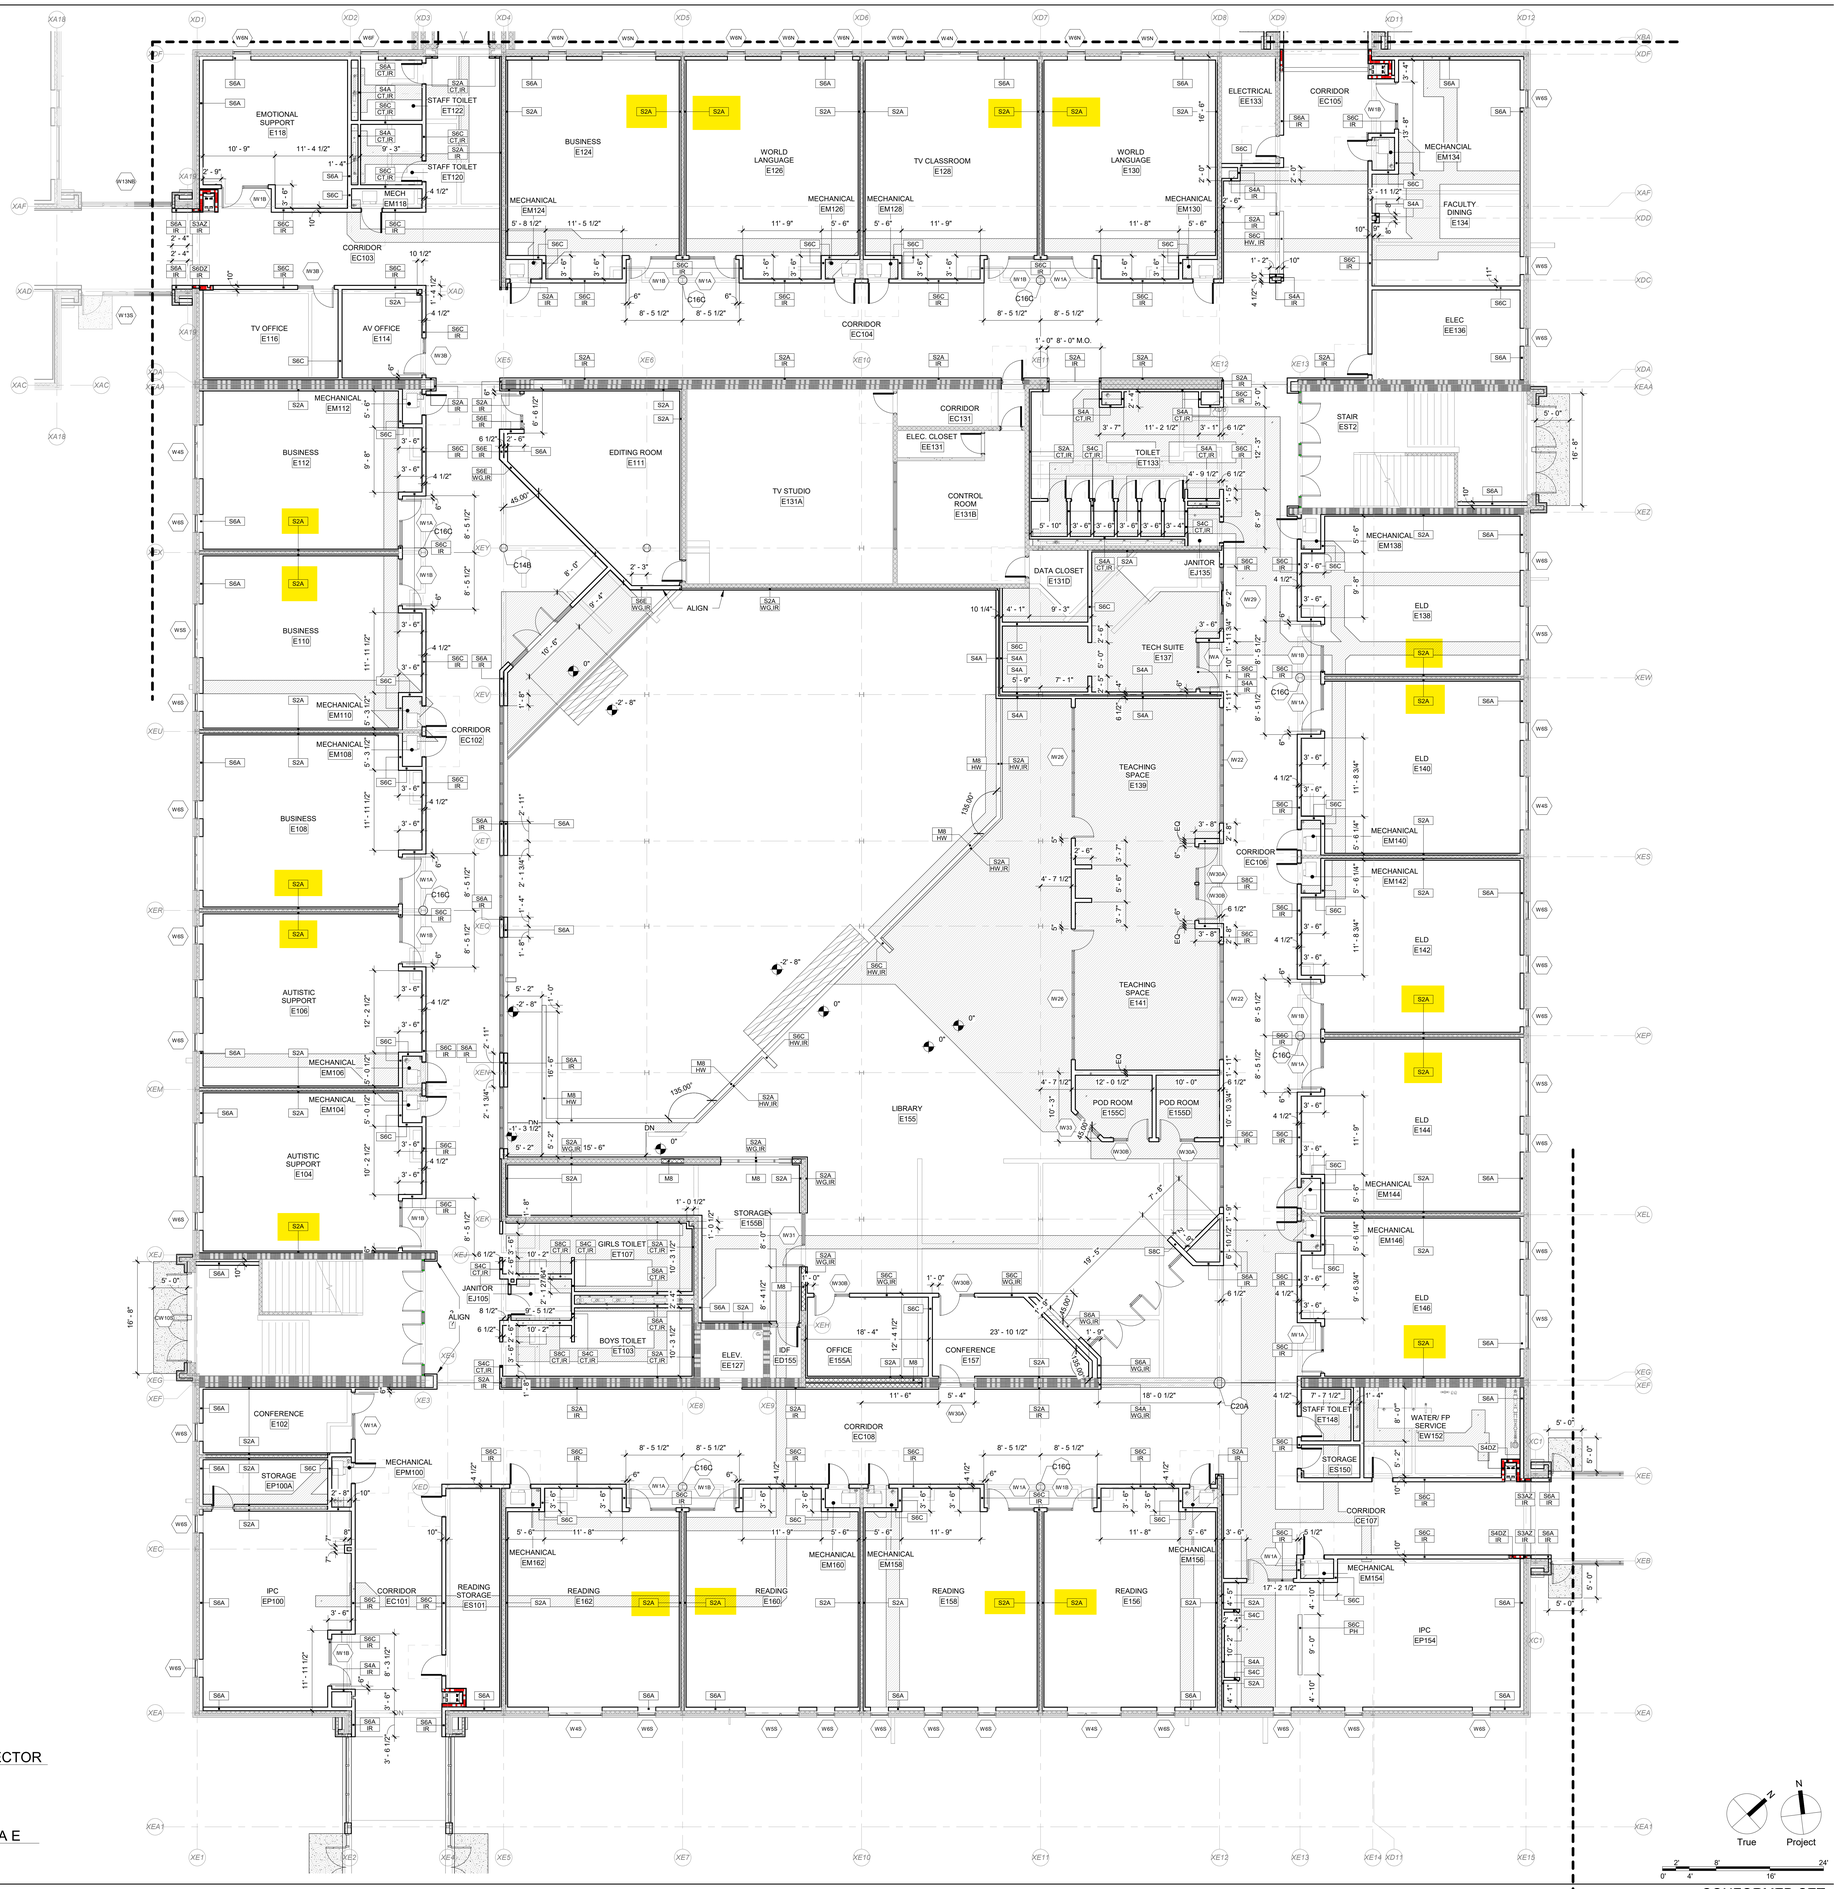

CONFORMED SET

SCHRADERGROUP
555 E North Lane, Suite 5100, Building D,
Conshohocken, PA 19428
p: 215 482 7440
f: 215 482 7441
www.sgarc.com

Consultants:

Civil:
T&M ASSOCIATES
1700 Market St, Suite 3110
Philadelphia, PA 19103
p: 215.282.7850

MEP:
Snyder Hoffman Associates, Inc.
1005 W. Lehigh St.
Bethlehem, PA 18018
p: 610.694.8020

Structural Engineer
SCHRADERGROUP
153 East King St. Suite 211-212
Lancaster, PA 17602
p: 717.299.8965

Food Service
Corsi Associates
1489 Baltimore Pike
Springfield, PA 19064
p: 866.267.7447

Acoustics
Metropolitan Acoustics
1628 John F Kennedy Blvd #1902
Philadelphia, PA 19103
p: 215.248.4352

Professional Seal:



Owner:
NORTH PENN SCHOOL DISTRICT
401 E. HANCOCK STREET, LANSDALE, PA 19446

Additions and Renovations to:
NORTH PENN HIGH SCHOOL - BID PACKAGE 2 (BP2)
1340 S. VALLEY FORGE RD. LANSDALE, PA 19446


ISSUED FOR:

NO.	DESCRIPTION	DATE
AD7	ADDENDUM #7	07/10/2025
AD9	ADDENDUM #9	07/24/2025
	CONFORMED SET	10/08/2025

DATE: 05/19/2025

SG PROJECT NUMBER: 23-028

Key Plan:
NOT IN SCOPE

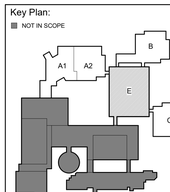

Drawing Title:
PARTIAL FIRST FLOOR DIMENSION PLAN - AREA E

Drawing Number:
BP2-A111.E

1. PREFIX CODES (CORE TYPES)

   S METAL STUD
   M MASONRY

2. FINISH CODES

   A (1) LAYER OF FINISH ON ONE SIDE
   B (2) LAYERS OF FINISH ON ONE SIDE
   C (1) LAYER OF FINISH ON BOTH SIDES
   D (2) LAYERS OF FINISH ON BOTH SIDES
   E (1) LAYER OF FINISH ON ONE SIDE, (2) LAYERS ON THE OTHER SIDE

3. RATING CODES

   X 1 HOUR FIRE RATED
   Z 2 HOUR FIRE RATED

4. SPECIAL CONDITION CODES

   CT WALL RECEIVES CERAMIC TILE FINISH OVER 5', REFERENCE GENERAL NOTE 41 ON A003. REFERENCE SPECIFICATIONS FOR SURFACE PREP REQUIREMENTS.

   HW HALF HEIGHT WALL, REFERENCE DETAILS FOR SPECIFIC WALL HEIGHT

   IR IMPACT RESISTANT GYPSUM WALL BOARD TO 10' ABOVE FINISHED FLOOR

   WG WALL RECIEVES VINYL WALL GRAPHIC. REFERENCE SPECIFICATIONS FOR SURFACE PREP REQUIREMENTS. REFERENCE ELEVATIONS FOR DIMENSIONS.

GENERAL PLAN NOTES

1. ALL DIMENSIONS ARE TO OUTSIDE FACE OF FOUNDATIONS, COLUMN LINE, OR FACE OF FRAMING UNLESS NOTED OTHERWISE. CONTRACTOR SHALL VERIFY DIMENSIONS PRIOR TO CONSTRUCTION AND NOTIFY ARCHITECT IMMEDIATELY OF ANY DISCREPANCIES.
2. SEE ENLARGED PLANS FOR TYPICAL INTERIOR ELEVATIONS.
3. FRAMING AND WALL FINISH SHALL BE CONTINUOUS ABOVE AND BELOW ALL WINDOW SYSTEMS.


NOT IN SCOPE

NEW CONCRETE SLAB, REFERENCE FLOOR PLANS FOR FLOOR HEIGHT

INFILL AREA. PROVIDE NEW CONCRETE SLAB FLUSH WITH EXISTING SLAB.

FROST SLAB, COORDINATE WITH SIDEWALK LAYOUT. REF. STRUCTURAL DRAWINGS FOR DETAIL.

NOTE: COORDINATE SLOPED SLAB W/ DRAINS. SEE STRUCTURAL AND PLUMBING DWGS.

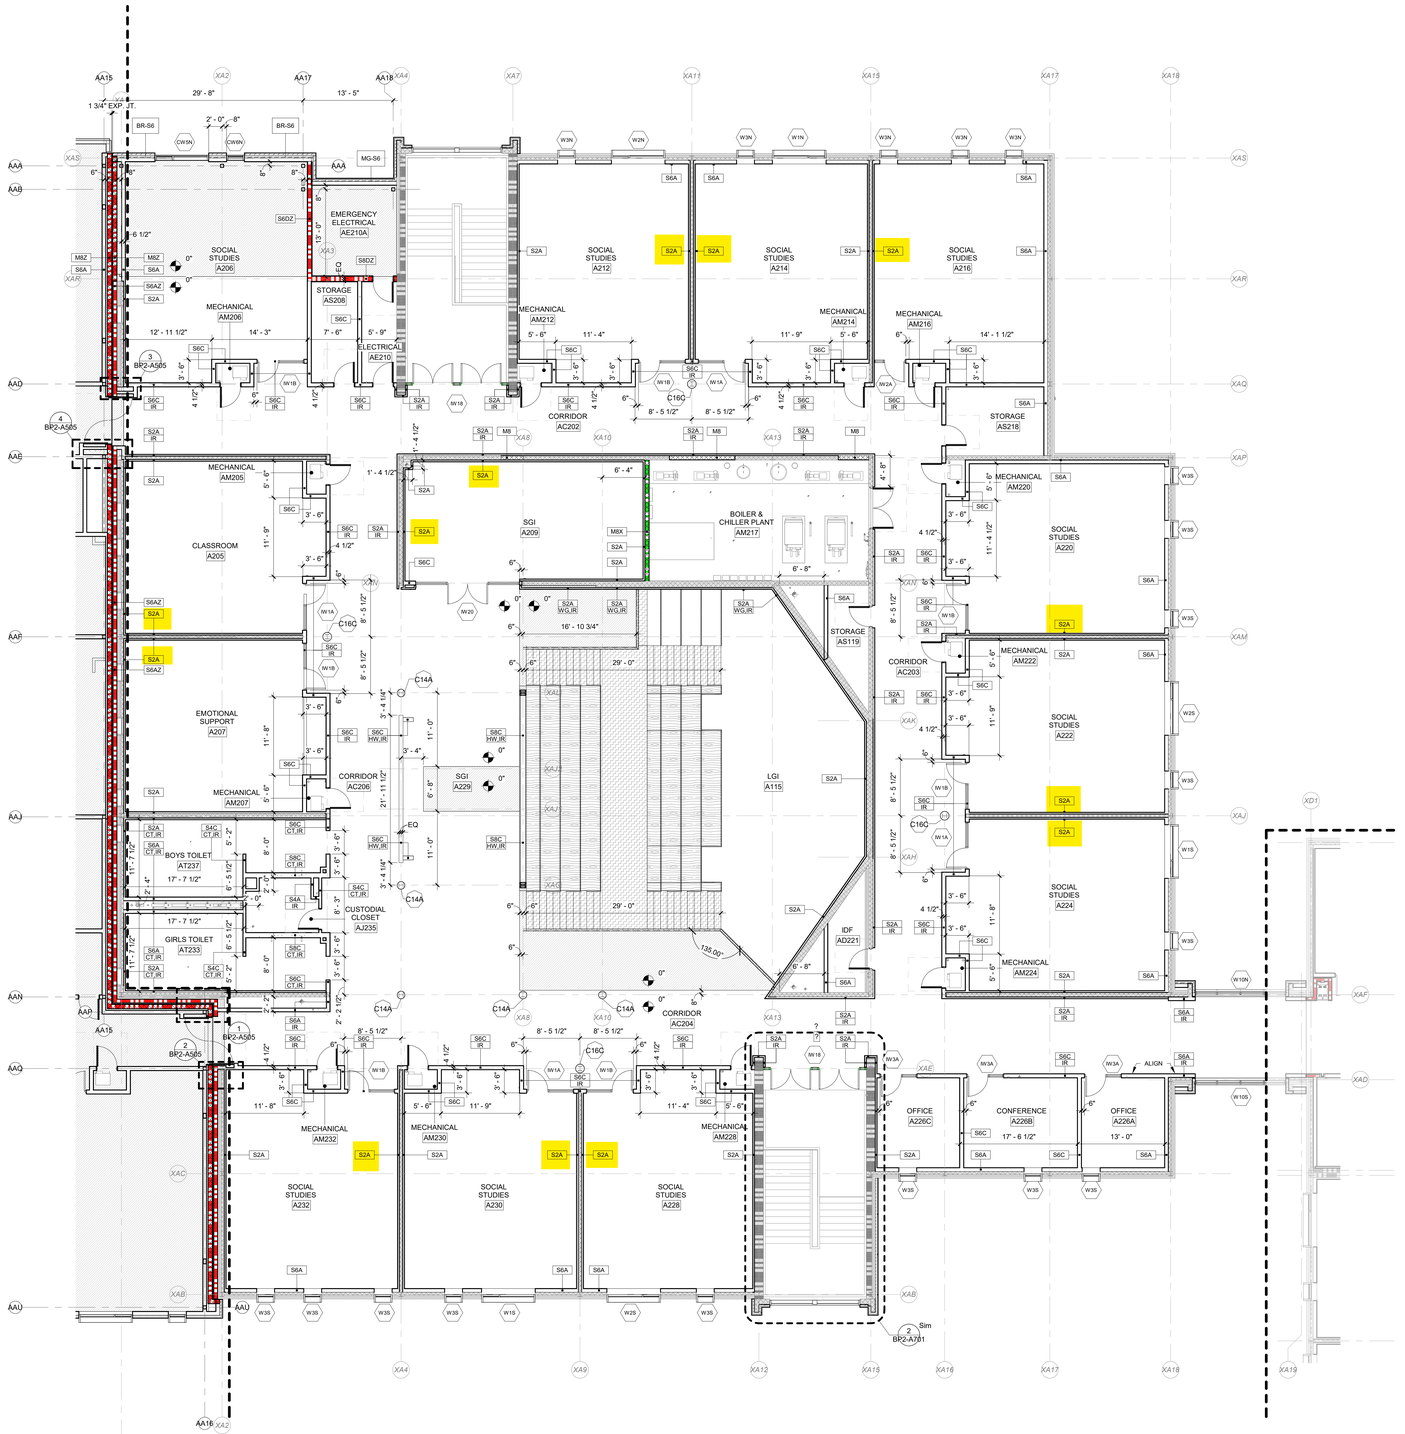

1 PARTIAL SECOND FLOOR PLAN - AREA A2
BP2-A112.A2 SCALE: 1/8" = 1'-0"

SCHRADERGROUP
555 E North Lane, Suite 5100, Building D,
Conshohocken, PA 19428
p: 215 482 7440
f: 215 482 7441
www.sgarc.com

Consultants:

Civil:
T&M ASSOCIATES
1700 Market St, Suite 3110
Philadelphia, PA 19103
p: 215.282.7850


MEP:
Snyder Hoffman Associates, Inc.
1005 W. Lehigh St.
Bethlehem, PA 18018
p: 610.694.8020

Structural Engineer
SCHRADERGROUP
153 East King St. Suite 211-212
Lancaster, PA 17602
p: 717.299.8965

Food Service
Corsi Associates
1489 Baltimore Pike
Springfield, PA 19064
p: 866.267.7447

Acoustics
Metropolitan Acoustics
1628 John F Kennedy Blvd #1902
Philadelphia, PA 19103
p: 215.248.4352

Professional Seal:

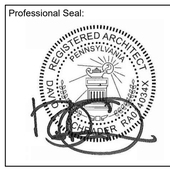

Owner:
NORTH PENN SCHOOL DISTRICT
401 E. HANCOCK STREET, LANSDALE, PA 19446

Additions and Renovations to:
NORTH PENN HIGH SCHOOL - BID PACKAGE 2 (BP2)
1340 S. VALLEY FORGE RD. LANSDALE, PA 19446


ISSUED FOR:

NO.	DESCRIPTION	DATE
ADB	ADDENDUM #8	07/17/2025
	CONFORMED SET	10/08/2025

DATE: 05/19/2025

SG PROJECT NUMBER: 23-028

Key Plan:
NOT IN SCOPE

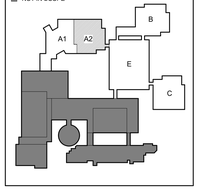

Drawing Title:
PARTIAL SECOND FLOOR DIMENSION PLAN - AREA A2

Drawing Number:
BP2-A112.A2

N
True Project
0' 2' 4' 8' 16' 24'

CONFORMED SET

1. PREFIX CODES (CORE TYPES)

   S METAL STUD
   M MASONRY

2. FINISH CODES

   A (1) LAYER OF FINISH ON ONE SIDE
   B (2) LAYERS OF FINISH ON ONE SIDE
   C (1) LAYER OF FINISH ON BOTH SIDES
   D (2) LAYERS OF FINISH ON BOTH SIDES
   E (1) LAYER OF FINISH ON ONE SIDE, (2) LAYERS ON THE OTHER SIDE

3. RATING CODES

   X 1 HOUR FIRE RATED
   Z 2 HOUR FIRE RATED

4. SPECIAL CONDITION CODES

   CT WALL RECEIVES CERAMIC TILE FINISH OVER 5', REFERENCE GENERAL NOTE 41 ON A003. REFERENCE SPECIFICATIONS FOR SURFACE PREP REQUIREMENTS.

   HW HALF HEIGHT WALL, REFERENCE DETAILS FOR SPECIFIC WALL HEIGHT

   IR IMPACT RESISTANT GYPSUM WALL BOARD TO 10' ABOVE FINISHED FLOOR

   WG WALL RECIEVES VINYL WALL GRAPHIC. REFERENCE SPECIFICATIONS FOR SURFACE PREP REQUIREMENTS. REFERENCE ELEVATIONS FOR DIMENSIONS.

GENERAL PLAN NOTES

1. ALL DIMENSIONS ARE TO OUTSIDE FACE OF FOUNDATIONS, COLUMN LINE, OR FACE OF FRAMING UNLESS NOTED OTHERWISE. CONTRACTOR SHALL VERIFY DIMENSIONS PRIOR TO CONSTRUCTION AND NOTIFY ARCHITECT IMMEDIATELY OF ANY DISCREPANCIES.
2. SEE ENLARGED PLANS FOR TYPICAL INTERIOR ELEVATIONS.
3. FRAMING AND WALL FINISH SHALL BE CONTINUOUS ABOVE AND BELOW ALL WINDOW SYSTEMS.


NOT IN SCOPE

NEW CONCRETE SLAB. REFERENCE FLOOR PLANS FOR FLOOR HEIGHT

INFILL AREA. PROVIDE NEW CONCRETE SLAB FLUSH WITH EXISTING SLAB.

FROST SLAB, COORDINATE WITH SIDEWALK LAYOUT. REF. STRUCTURAL DRAWINGS FOR DETAIL.

NOTE: COORDINATE SLOPED SLAB W/ DRAINS. SEE STRUCTURAL AND PLUMBING DWGS.

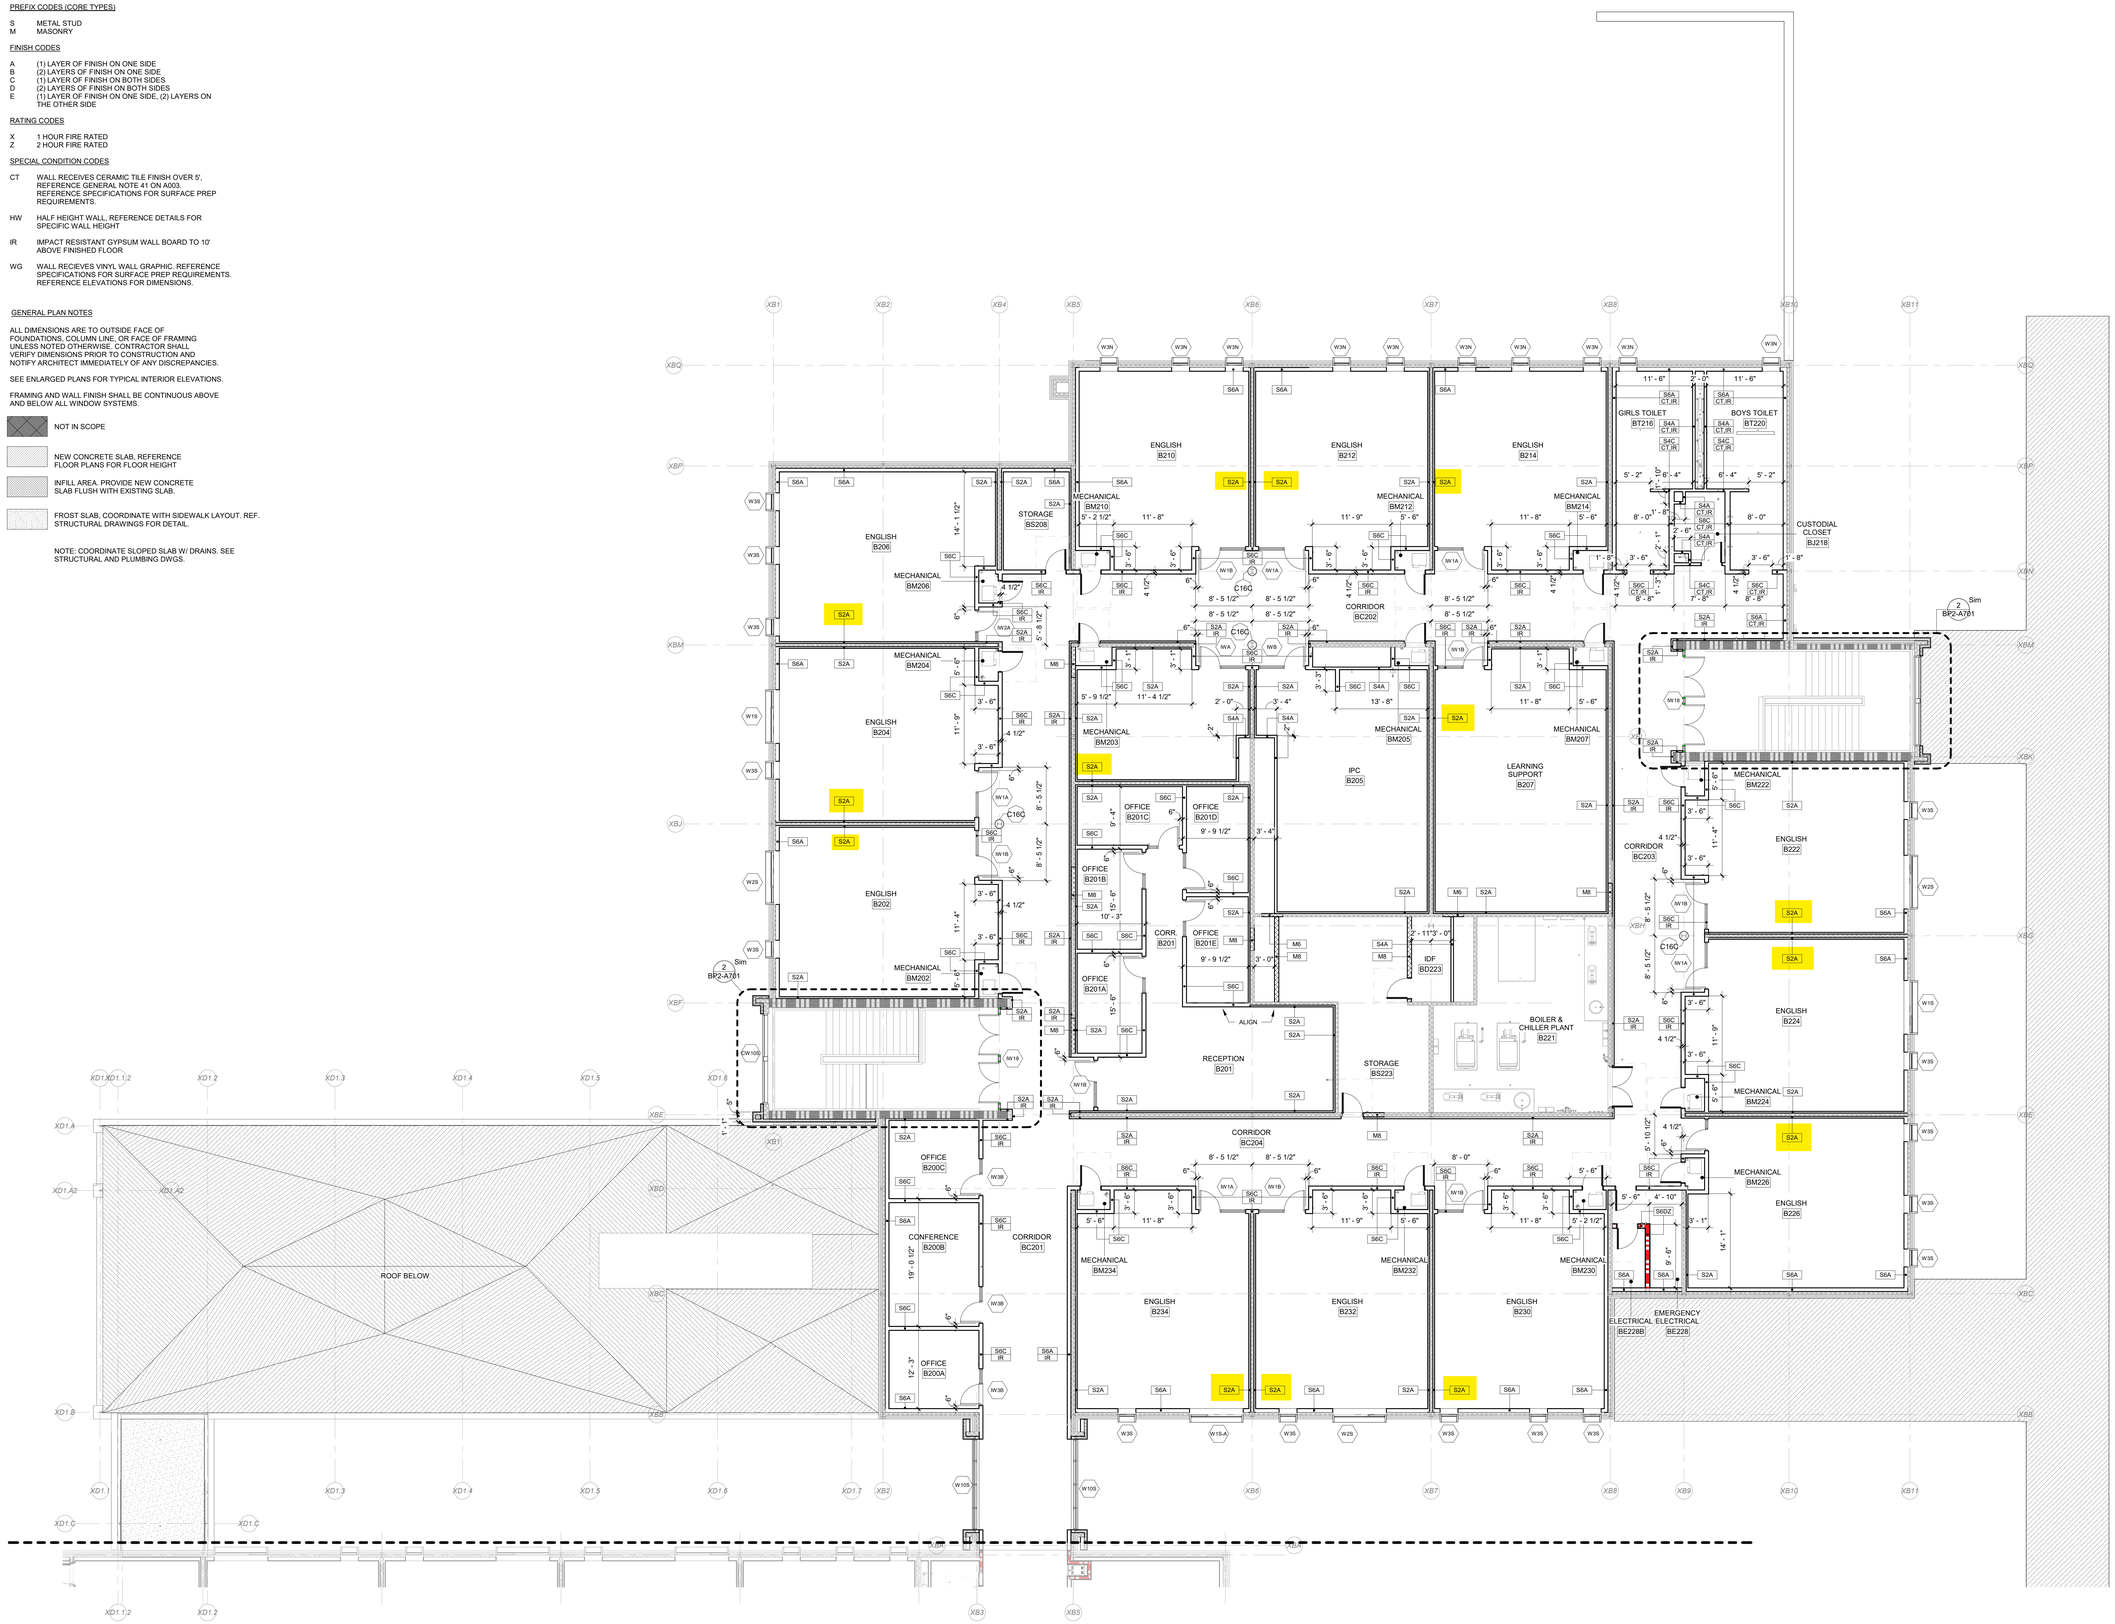

1 | PARTIAL SECOND FLOOR PLAN - AREA B
BP2-A112.B | SCALE: 1/8" = 1'-0"

SCHRADERGROUP
555 E North Lane, Suite 5100, Building D,
Conshohocken, PA 19428
p: 215 482 7440
f: 215 482 7441
www.sgarc.com

Consultants:

Civil:
T&M ASSOCIATES
1700 Market St, Suite 3110
Philadelphia, PA 19103
p: 215.282.7850

MEP:
Snyder Hoffman Associates, Inc.
1005 W. Lehigh St.
Bethlehem, PA 18018
p: 610.694.8020

Structural Engineer
SCHRADERGROUP
153 East King St. Suite 211-212
Lancaster, PA 17602
p: 717.299.8965

Food Service
Corsi Associates
1489 Baltimore Pike
Springfield, PA 19064
p: 866.267.7447

Acoustics
Metropolitan Acoustics
1628 John F Kennedy Blvd #1902
Philadelphia, PA 19103
p: 215.248.4352

Professional Seal:



Owner:
NORTH PENN SCHOOL DISTRICT
401 E. HANCOCK STREET, LANSDALE, PA 19446

Additions and Renovations to:
NORTH PENN HIGH SCHOOL - BID PACKAGE 2 (BP2)
1340 S. VALLEY FORGE RD. LANSDALE, PA 19446

ISSUED FOR:

NO.	DESCRIPTION	DATE
AD8	ADDENDUM #8	07/17/2025
	CONFORMED SET	10/08/2025

DATE: 05/19/2025


SG PROJECT NUMBER: 23-028

Key Plan:



Drawing Title:
PARTIAL SECOND FLOOR DIMENSION PLAN - AREA B

Drawing Number:
BP2-A112.B

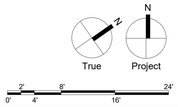

CONFORMED SET

1. PREFIX CODES (CORE TYPES)

   S METAL STUD
   M MASONRY

2. FINISH CODES

   A (1) LAYER OF FINISH ON ONE SIDE
   B (2) LAYERS OF FINISH ON ONE SIDE
   C (1) LAYER OF FINISH ON BOTH SIDES
   D (2) LAYERS OF FINISH ON BOTH SIDES
   E (1) LAYER OF FINISH ON ONE SIDE, (2) LAYERS ON THE OTHER SIDE

3. RATING CODES

   X 1 HOUR FIRE RATED
   Z 2 HOUR FIRE RATED

4. SPECIAL CONDITION CODES

   CT WALL RECEIVES CERAMIC TILE FINISH OVER 5', REFERENCE GENERAL NOTE 41 ON A003. REFERENCE SPECIFICATIONS FOR SURFACE PREP REQUIREMENTS.

   HW HALF HEIGHT WALL. REFERENCE DETAILS FOR SPECIFIC WALL HEIGHT

   IR IMPACT RESISTANT GYPSUM WALL BOARD TO 10' ABOVE FINISHED FLOOR

   WG WALL RECIEVES VINYL WALL GRAPHIC. REFERENCE SPECIFICATIONS FOR SURFACE PREP REQUIREMENTS. REFERENCE ELEVATIONS FOR DIMENSIONS.

GENERAL PLAN NOTES

1. ALL DIMENSIONS ARE TO OUTSIDE FACE OF FOUNDATIONS, COLUMN LINE, OR FACE OF FRAMING UNLESS NOTED OTHERWISE. CONTRACTOR SHALL VERIFY DIMENSIONS PRIOR TO CONSTRUCTION AND NOTIFY ARCHITECT IMMEDIATELY OF ANY DISCREPANCIES.
2. SEE ENLARGED PLANS FOR TYPICAL INTERIOR ELEVATIONS.
3. FRAMING AND WALL FINISH SHALL BE CONTINUOUS ABOVE AND BELOW ALL WINDOW SYSTEMS.


NOT IN SCOPE

NEW CONCRETE SLAB. REFERENCE FLOOR PLANS FOR FLOOR HEIGHT

INFILL AREA. PROVIDE NEW CONCRETE SLAB FLUSH WITH EXISTING SLAB.

FROST SLAB, COORDINATE WITH SIDEWALK LAYOUT. REF. STRUCTURAL DRAWINGS FOR DETAIL

NOTE: COORDINATE SLOPED SLAB W/ DRAINS. SEE STRUCTURAL AND PLUMBING DWGS.

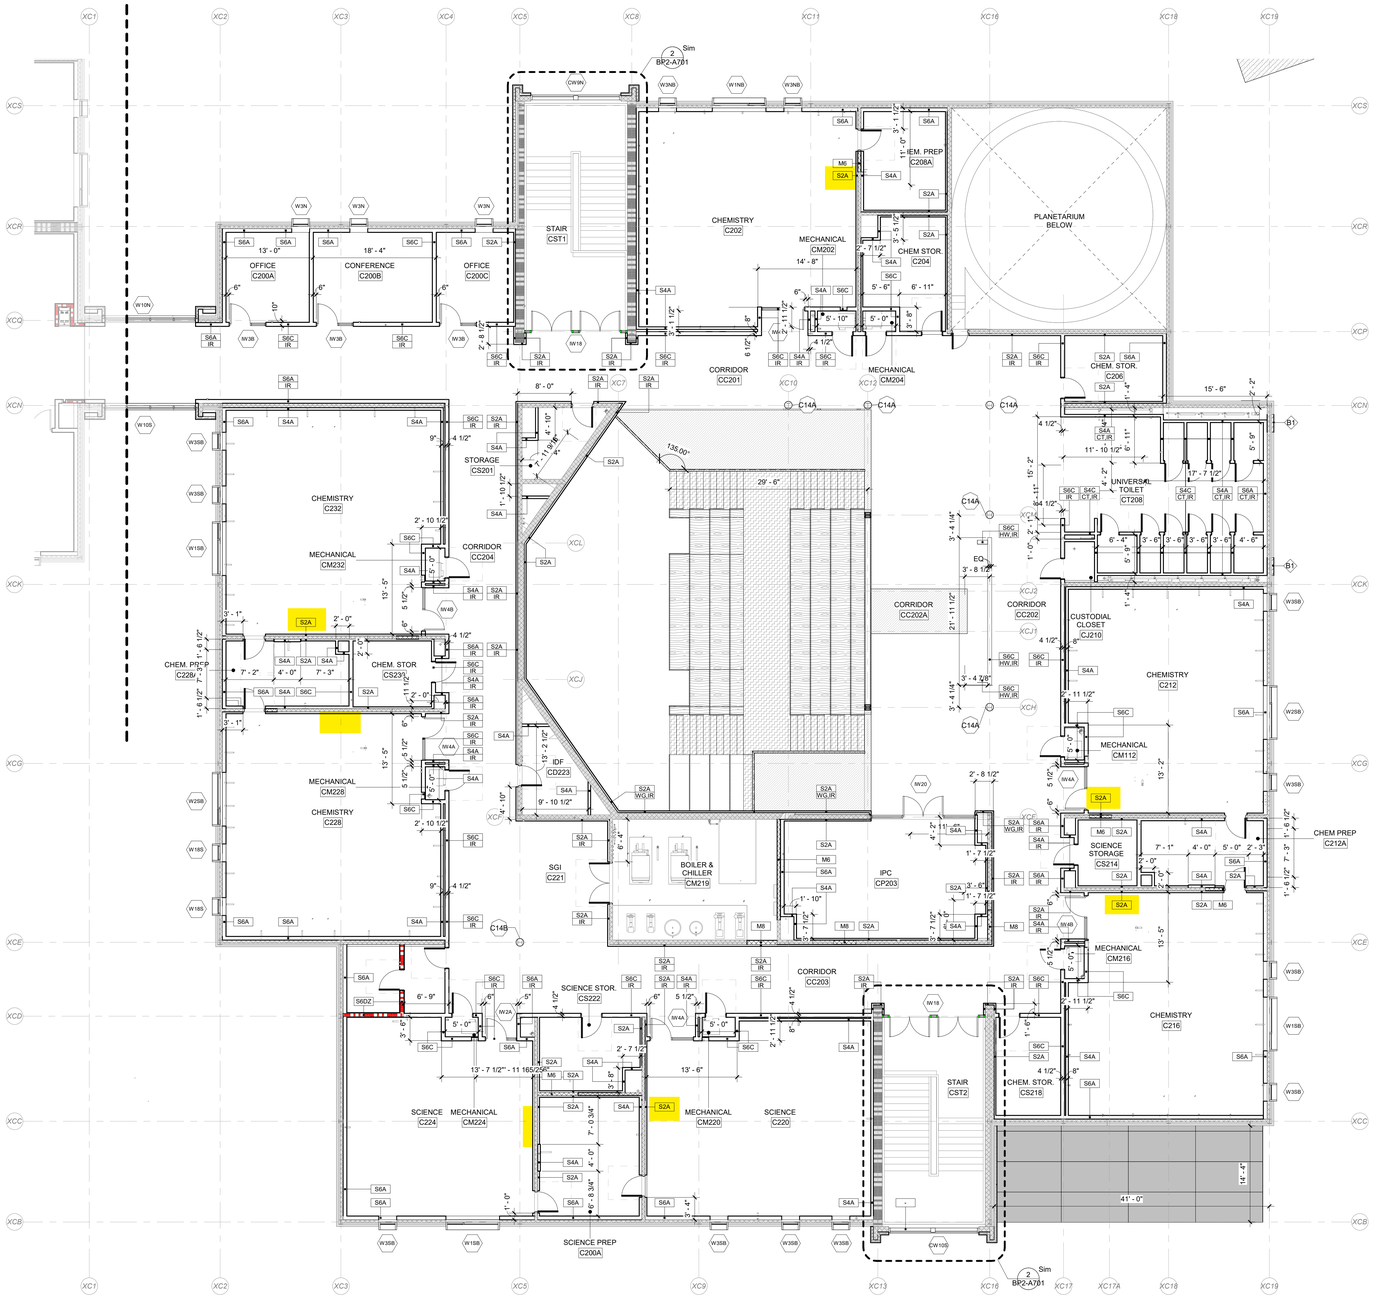

1 PARTIAL SECOND FLOOR PLAN - AREA C
BP2-A112.C SCALE: 1/8" = 1'-0"

SCHRADERGROUP
555 E North Lane, Suite 5100, Building D,
Conshohocken, PA 19428
p: 215 482 7440
f: 215 482 7441
www.sgarc.com

Consultants:

Civil:
T&M ASSOCIATES
1700 Market St, Suite 3110
Philadelphia, PA 19103
p: 215.282.7850

MEP:
Snyder Hoffman Associates, Inc.
1005 W. Lehigh St.
Bethlehem, PA 18018
p: 610.694.8020

Structural Engineer
SCHRADERGROUP
153 East King St. Suite 211-212
Lancaster, PA 17602
p: 717.299.8965

Food Service
Corsi Associates
1489 Baltimore Pike
Springfield, PA 19064
p: 866.267.7447

Acoustics
Metropolitan Acoustics
1628 John F Kennedy Blvd #1902
Philadelphia, PA 19103
p: 215.248.4352

Professional Seal:



Owner:
NORTH PENN SCHOOL DISTRICT
401 E. HANCOCK STREET, LANSDALE, PA 19446

Additions and Renovations to:
NORTH PENN HIGH SCHOOL - BID PACKAGE 2 (BP2)
1340 S. VALLEY FORGE RD.
LANSDALE, PA 19446


ISSUED FOR:

NO.	DESCRIPTION	DATE
ADT	ADDENDUM #7	07/10/2025
	CONFORMED SET	10/08/2025

DATE: 05/19/2025


SG PROJECT NUMBER: 23-028

Key Plan:
NOT IN SCOPE

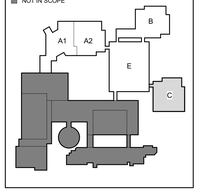

Drawing Title:
PARTIAL SECOND FLOOR DIMENSION PLAN - AREA C

Drawing Number:
BP2-A112.C

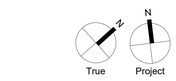

0' 2' 4' 8' 16' 24'

1. PREFIX CODES (CORE TYPES)

S METAL STUD
M MASONRY

2. FINISH CODES

A (1) LAYER OF FINISH ON ONE SIDE
B (2) LAYERS OF FINISH ON ONE SIDE
C (1) LAYER OF FINISH ON BOTH SIDES
D (2) LAYERS OF FINISH ON BOTH SIDES
E (1) LAYER OF FINISH ON ONE SIDE, (2) LAYERS ON THE OTHER SIDE

3. RATING CODES

X 1 HOUR FIRE RATED
Z 2 HOUR FIRE RATED

4. SPECIAL CONDITION CODES

CT WALL RECEIVES CERAMIC TILE FINISH OVER 5', REFERENCE GENERAL NOTE 41 ON A003. REFERENCE SPECIFICATIONS FOR SURFACE PREP REQUIREMENTS.

HW HALF HEIGHT WALL, REFERENCE DETAILS FOR SPECIFIC WALL HEIGHT

IR IMPACT RESISTANT GYPSUM WALL BOARD TO 10' ABOVE FINISHED FLOOR

WG WALL RECEIVES VINYL WALL GRAPHIC. REFERENCE SPECIFICATIONS FOR SURFACE PREP REQUIREMENTS. REFERENCE ELEVATIONS FOR DIMENSIONS.

GENERAL PLAN NOTES

1. ALL DIMENSIONS ARE TO OUTSIDE FACE OF FOUNDATIONS, COLUMN LINE, OR FACE OF FRAMING UNLESS NOTED OTHERWISE. CONTRACTOR SHALL VERIFY DIMENSIONS PRIOR TO CONSTRUCTION AND NOTIFY ARCHITECT IMMEDIATELY OF ANY DISCREPANCIES.
2. SEE ENLARGED PLANS FOR TYPICAL INTERIOR ELEVATIONS.
3. FRAMING AND WALL FINISH SHALL BE CONTINUOUS ABOVE AND BELOW ALL WINDOW SYSTEMS.


NOT IN SCOPE

NEW CONCRETE SLAB, REFERENCE FLOOR PLANS FOR FLOOR HEIGHT

INFILL AREA. PROVIDE NEW CONCRETE SLAB FLUSH WITH EXISTING SLAB.

FROST SLAB, COORDINATE WITH SIDEWALK LAYOUT. REF. STRUCTURAL DRAWINGS FOR DETAIL.

NOTE: COORDINATE SLOPED SLAB W/ DRAINS. SEE STRUCTURAL AND PLUMBING DWGS.

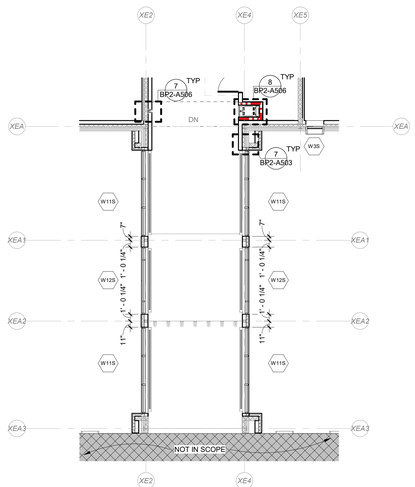

2 PARTIAL SECOND FLOOR DIMENSION PLAN - AREA E/F CONNECTOR
BP2-A112.E SCALE: 1/8" = 1'-0"

1 PARTIAL SECOND FLOOR PLAN - AREA E
BP2-A112.E SCALE: 1/8" = 1'-0"

SCHRADERGROUP
555 E North Lane, Suite 5100, Building D,
Conshohocken, PA 19428
p: 215 482 7440
f: 215 482 7441
www.sgarc.com

Consultants:

Civil:
T&M ASSOCIATES
1700 Market St, Suite 3110
Philadelphia, PA 19103
p: 215.282.7850

MEP:
Snyder Hoffman Associates, Inc.
1005 W. Lehigh St.
Bethlehem, PA 18018
p: 610.694.8020

Structural Engineer
SCHRADERGROUP
153 East King St. Suite 211-212
Lancaster, PA 17602
p: 717.299.8965

Food Service
Corsi Associates
1489 Baltimore Pike
Springfield, PA 19064
p: 866.267.7447

Acoustics
Metropolitan Acoustics
1628 John F Kennedy Blvd #1902
Philadelphia, PA 19103
p: 215.248.4352

Professional Seal:



Owner:
NORTH PENN SCHOOL DISTRICT
401 E. HANCOCK STREET, LANSDALE, PA 19446

Additions and Renovations to:
NORTH PENN HIGH SCHOOL - BID PACKAGE 2 (BP2)
1340 S. VALLEY FORGE RD.
LANSDALE, PA 19446


ISSUED FOR:

NO.	DESCRIPTION	DATE
AD7	ADDENDUM #7	07/10/2025
	CONFORMED SET	10/08/2025

DATE: 05/19/2025

SG PROJECT NUMBER: 23-028

Key Plan:
NOT IN SCOPE

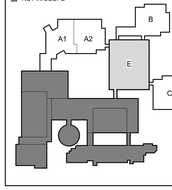

Drawing Title:
PARTIAL SECOND FLOOR DIMENSION PLAN - AREA E

Drawing Number:
BP2-A112.E

True Project
0' 2' 4' 8' 16' 24'

CONFORMED SET